


NOTE:
 LOTS 1 AND 2 OF REPLAT 3 STUB LOCATIONS
 ARE BASED OFF ORIGINAL LOTS 650 AND 651
 STUB LOCATIONS

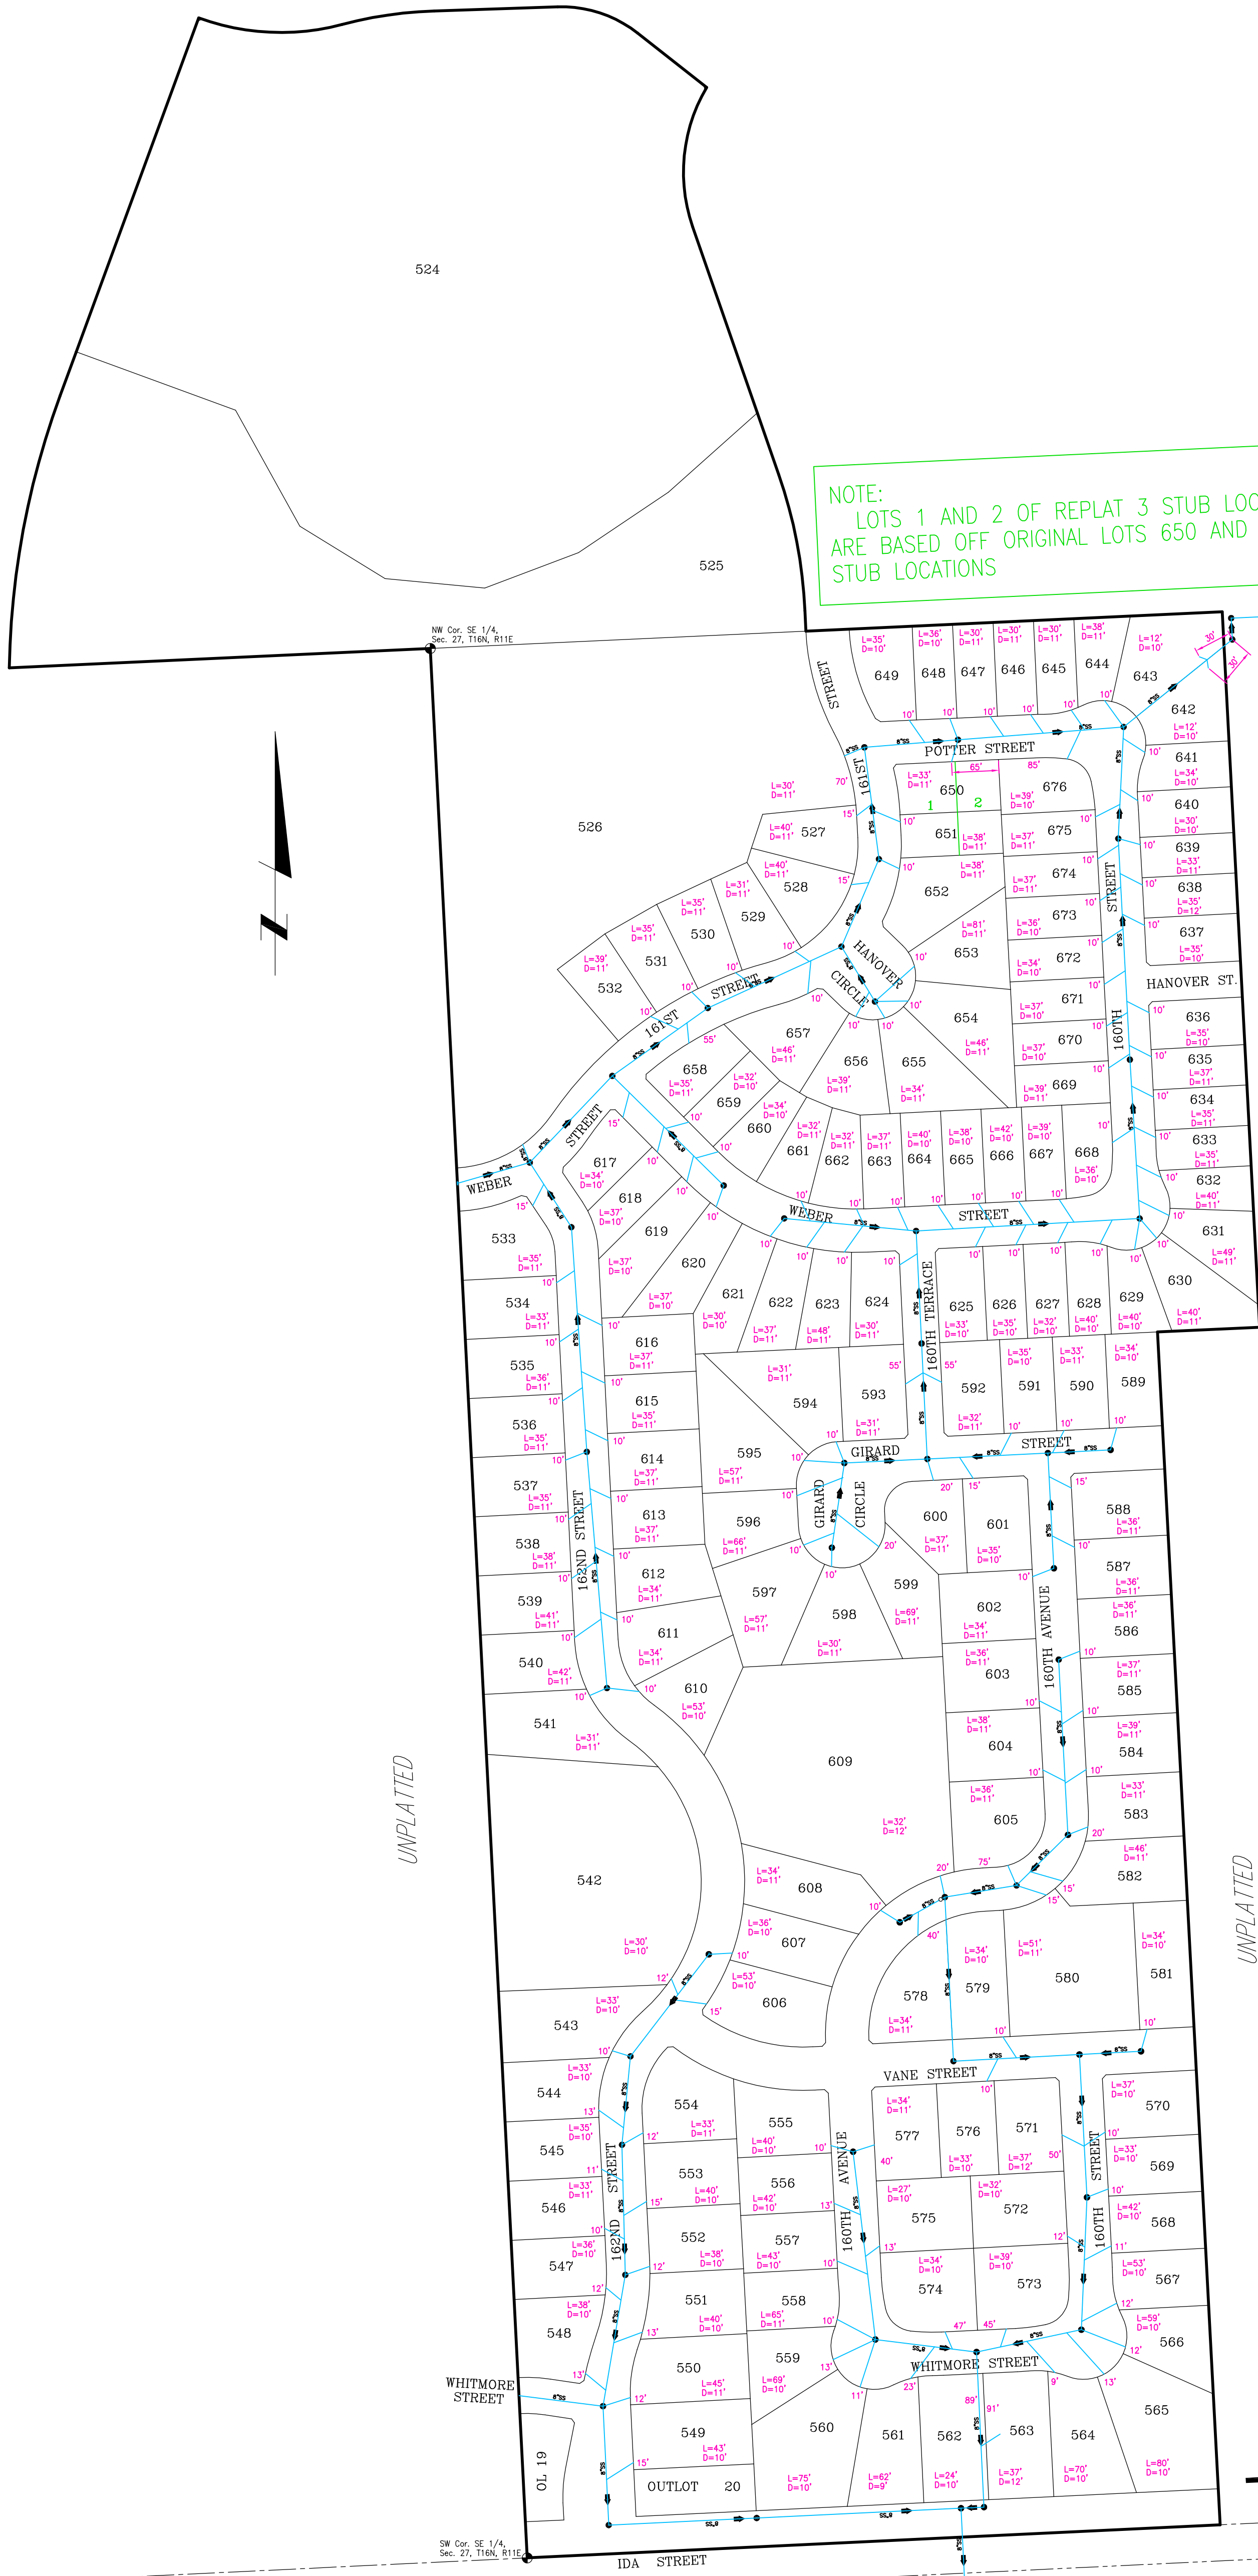

These Record Drawings have been prepared based on information submitted, in part, by others. While this information is believed to be reliable, the Engineer is not responsible for its accuracy, nor for errors or omissions which may have been incorporated into this document as a result.

Retain the Location Request Number for YOUR Own Protection!



METROPOLITAN UTILITIES DISTRICT
 OMAHA PUBLIC POWER DISTRICT
 QWEST
 CITY OF OMAHA
 CABLEVISION
 COX CABLE OF OMAHA
 PEOPLES NATURAL GAS
 NORTHERN NATURAL GAS
 UNITED CABLE TELEVISION

lamp, ryneason & associates, inc.
 engineers surveyors planners
 14710 west dodge road, suite 100
 omaha, nebraska 68154 2029
 ph 402 496 2498
 fax 402 496 2730